


VIEW ON UNDERSIDE OF CELL EXTENSION/CABLE WRAP ASSY.




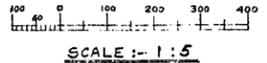


SCALE :- 1:5

AS BUILT DRAWINGS
This drawing shows all revisions to this work.

FREEMAN FOX & PARTNERS APPROVED No. TCI 272 Rev. E Date 23-3-1983 by JLC	FREEMAN FOX & PARTNERS APPROVED No. TCI 272 Rev. D Date 26-1-1983 by GPC	FREEMAN FOX & PARTNERS APPROVED No. TCI 272 Rev. C Date 22-4-1982 by JLC	FREEMAN FOX & PARTNERS APPROVED No. TCI 272 Rev. A Date 2-7-1982 by JLC
--	--	--	---

DATE OF MOD 20/7/83 MODIFIED BY L. T. H. E. REASON FOR MODIFICATION: P.S. ADDED.	DATE OF MOD 5-8-82 MODIFIED BY R. BROWN REASON FOR MODIFICATION: PROFILE OF NUTS ON SCREW A-A & SECTION B-B COMPLETED.	DATE OF MOD 20-1-83 MODIFIED BY J. G. C. REASON FOR MODIFICATION: DIMENSIONS OF NUTS ON SCREW A-A & B-B MODIFIED DUE TO CHANGE BY MANUFACTURER.
--	--	---

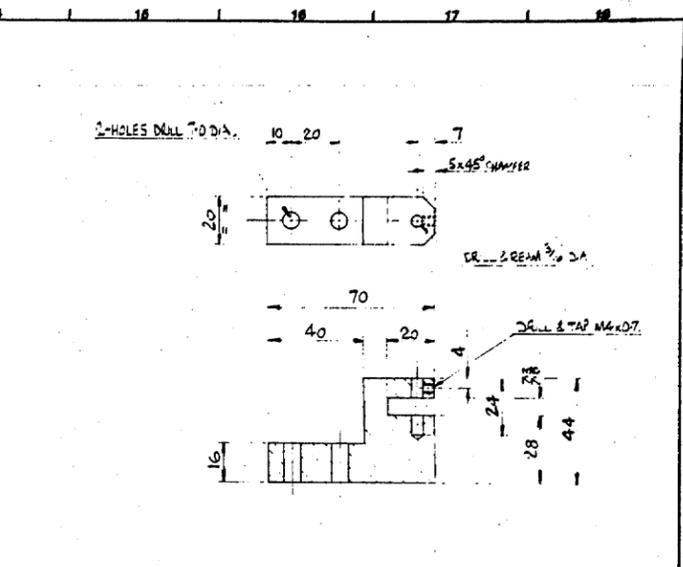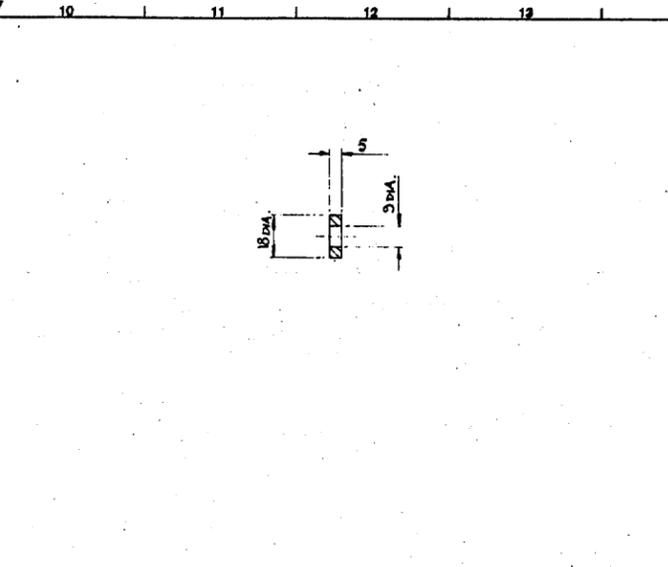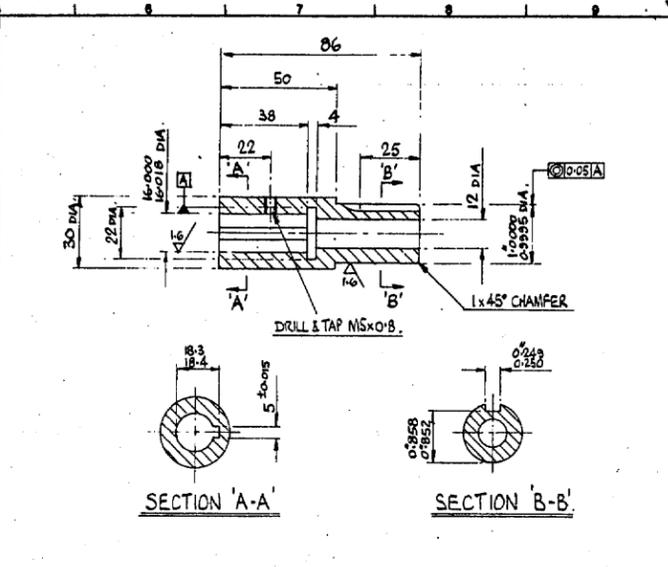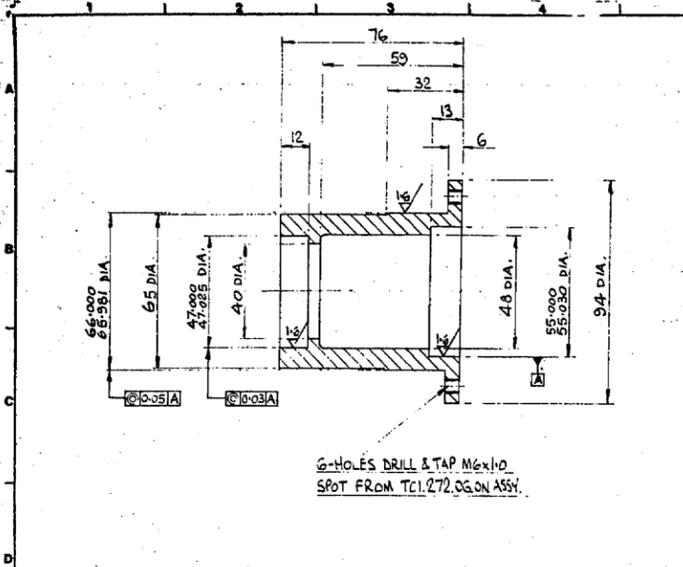

3/2 EXCEPT WHERE SHOWN

FREEMAN FOX & PARTNERS
APPROVED
 No. TCI.272.11 Rev. A
 Date 2.7.1982

3/2 EXCEPT WHERE SHOWN

FREEMAN FOX & PARTNERS
APPROVED
 No. TCI.272.12 Rev. A
 Date 2.7.1982

3/2 ALL OVER

FREEMAN FOX & PARTNERS
APPROVED
 No. TCI.272.13 Rev. A
 Date 2.7.1982

3/2 ALL OVER




FREEMAN FOX & PARTNERS
APPROVED
 No. TCI.272.14 Rev. A
 Date 2.7.1982

DATE OF MOD MODIFIED BY	DATE OF MOD MODIFIED BY	FIRST MADE ORD No. 118764	MATERIAL STEEL
		FIRST ISSUE DATE	BS970-EN3A
		COST ACCOUNT 272	FINISH NATURAL
			PATT No.
TITLE BEARINGS HOUSING			
WEIGHT 1.06 Kg	SCALE 1/1	UNIT No. TCI.272.11	ISSUE A
No. OFF PER SET 2			

DATE OF MOD MODIFIED BY	DATE OF MOD MODIFIED BY	FIRST MADE ORD No. 118764	MATERIAL STEEL
		FIRST ISSUE DATE	BS970-EN3A
		COST ACCOUNT 272	FINISH NATURAL
			PATT No.
TITLE SHAFT EXTENSION			
WEIGHT 0.31 Kg	SCALE 1/1	UNIT No. TCI.272.12	ISSUE A
No. OFF PER SET 1			

DATE OF MOD MODIFIED BY	DATE OF MOD MODIFIED BY	FIRST MADE ORD No. 118764	MATERIAL STEEL
		FIRST ISSUE DATE	BS970-EN3A
		COST ACCOUNT 272	FINISH NATURAL
			PATT No.
TITLE SPACER			
WEIGHT 0.28 Kg	SCALE 1/1	UNIT No. TCI.272.13	ISSUE A
No. OFF PER SET 4			

DATE OF MOD MODIFIED BY	DATE OF MOD MODIFIED BY	FIRST MADE ORD No. 118764	MATERIAL STEEL
		FIRST ISSUE DATE	20' CARBON
		COST ACCOUNT 272	FINISH FILE GREEN MCS
			PATT No.
TITLE TRANSDUCER ANCHOR BRACKET			
WEIGHT 0.28 Kg	SCALE 1/1	UNIT No. TCI.272.14	ISSUE A
No. OFF PER SET 1			

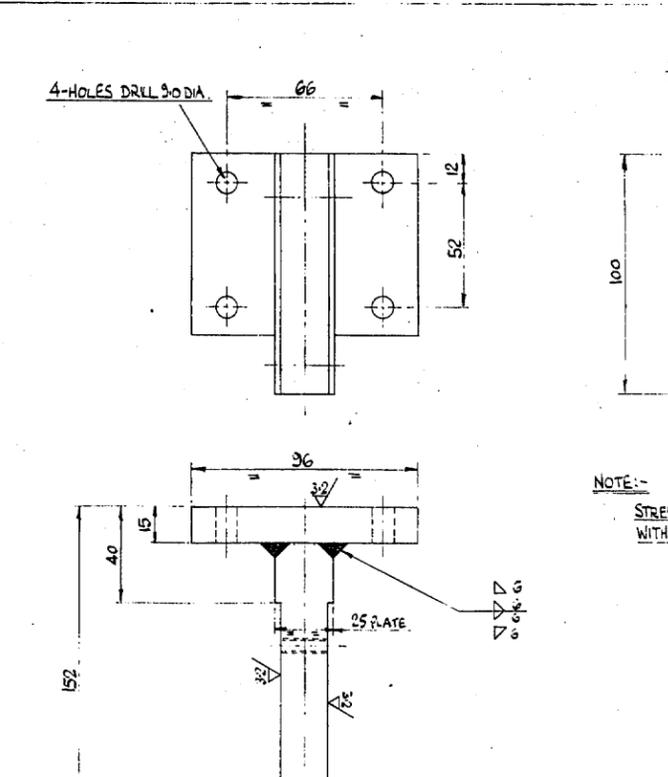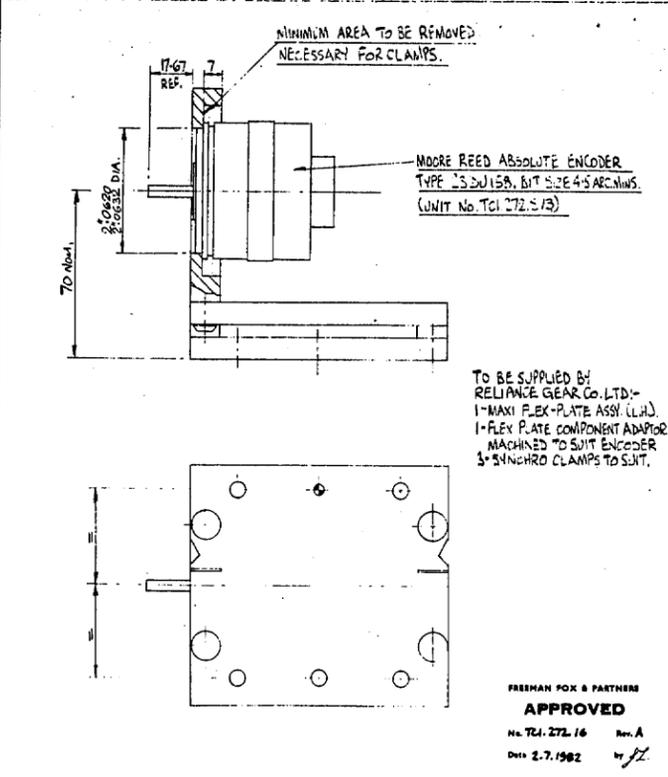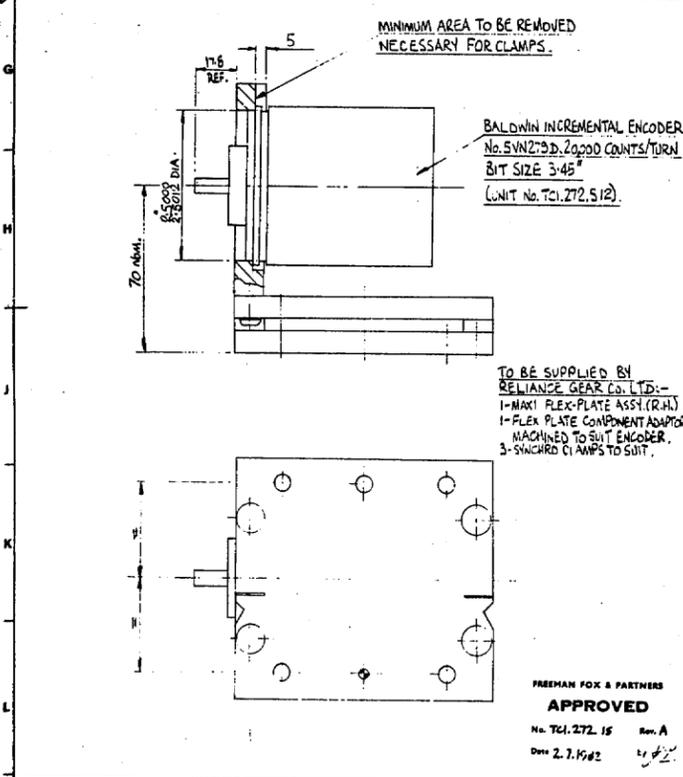

NOTE:- STRESS RELIEVE WITH BLAST & PAINT WITH PRIMER BEFORE MACHINING.

FREEMAN FOX & PARTNERS
AS BUILT DRAWINGS
 This drawing shows all revisions to this work.

FREEMAN FOX & PARTNERS
APPROVED
 No. TCI.272.17 Rev. A
 Date 2.7.1982

DATE OF MOD MODIFIED BY	DATE OF MOD MODIFIED BY	FIRST MADE ORD No. 118764	MATERIAL AS SUPPLIED
		FIRST ISSUE DATE	SEE TCI.272.510
		COST ACCOUNT 272	FINISH
			PATT No.
TITLE BALDWIN ENCODER & MOUNTING ASSEMBLY			
WEIGHT 3.06 Kg	SCALE 1/1	UNIT No. TCI.272.15	ISSUE A
No. OFF PER SET 1			

DATE OF MOD MODIFIED BY	DATE OF MOD MODIFIED BY	FIRST MADE ORD No. 118764	MATERIAL AS SUPPLIED
		FIRST ISSUE DATE	SEE TCI.272.511
		COST ACCOUNT 272	FINISH
			PATT No.
TITLE MOORE REED ENCODER & MOUNTING ASSEMBLY			
WEIGHT 3.06 Kg	SCALE 1/1	UNIT No. TCI.272.16	ISSUE A
No. OFF PER SET 1			

DATE OF MOD MODIFIED BY	DATE OF MOD MODIFIED BY	FIRST MADE ORD No. 118764	MATERIAL STEEL
		FIRST ISSUE DATE	BS970-EN3A
		COST ACCOUNT 272	FINISH FILE GREEN MCS
			PATT No.
TITLE BRACKET			
WEIGHT 3.06 Kg	SCALE 1/1	UNIT No. TCI.272.17	ISSUE A
No. OFF PER SET 1			

4.2 METRE WINDMILL RECONSTRUCTION PROJECT

GRUBB PARSONS NEWCASTLE UPON TYNE NE6 2YB

TITLE DETAILS OF CASSEGRAIN TURNTABLE

SCALE

DRAWN DATE 17/5/82

