



2-HOLE 13.0 DIA.
12 MM THICK.
REMOVE ALL BURRS & SHARP EDGES.

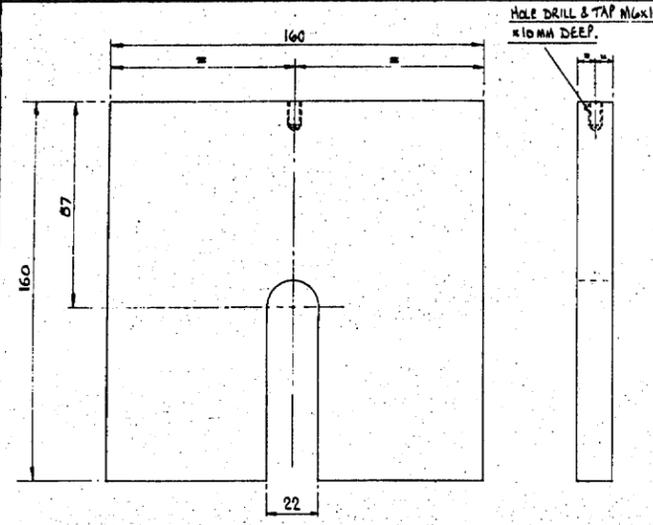

THICKNESS TO BE DETERMINED ON ASSY. (USE 20MM PLATE)
FINISH - PAINT EDGES HARD GLOSS PALE GREEN 14C31.
3/2 ALL OVER.

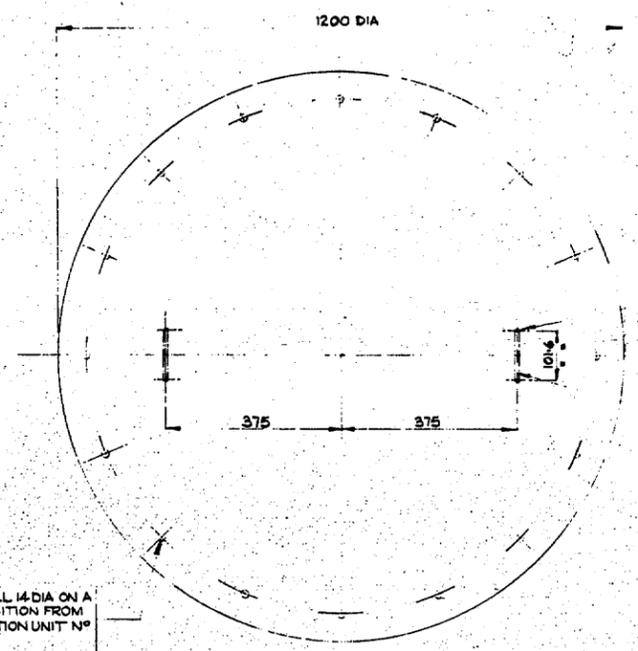

2-SETS OF 2-HOLES
DRILL 7/32" DIA

NOTES
1. THIS COVER PLATE TO BE ATTACHED TO CENTRE SECTION UNIT N° TC1 202.03 USING 1/2" DIA SCREWS UNIT N° TC1 202.01
2. HANDLE SIDE OFF PLATE TO BE PAINTED HARD GLOSS PALE GREEN 14C31, OTHER SIDE TO BE PAINTED DURABLE MATT BLACK.

FREEMAN FOX & PARTNERS
APPROVED
No. TC1.202.06
Date 20.1.1982


FREEMAN FOX & PARTNERS
APPROVED
No. TC1.202.07
Date 2.7.1982

FREEMAN FOX & PARTNERS
APPROVED
No. TC1.202.08
Date 26.1.1983



DATE OF MODIFIED BY	DATE OF MODIFIED BY	FIRST MADE ORN No.	ISSUE	MATERIAL	FINISH
		TC1.202.06	1	STEEL	SEE ABOVE
DATE OF MODIFIED BY	DATE OF MODIFIED BY	FIRST ISSUE DATE	COST ACCOUNT	PART No.	
			202		
DATE OF MODIFIED BY	DATE OF MODIFIED BY	TITLE	WEIGHT	SCALE	UNIT No.
		LABOUR TIE	2.8 kg	1/2	TC1.202.06
			No. OFF PER SET		ISSUE
			4		A

DATE OF MODIFIED BY	DATE OF MODIFIED BY	FIRST MADE ORN No.	ISSUE	MATERIAL	FINISH
		118764	1	STEEL	SEE ABOVE
DATE OF MODIFIED BY	DATE OF MODIFIED BY	FIRST ISSUE DATE	COST ACCOUNT	PART No.	
			202		
DATE OF MODIFIED BY	DATE OF MODIFIED BY	TITLE	WEIGHT	SCALE	UNIT No.
		SHIM	2.8 kg	1/2	TC1.202.07
			No. OFF PER SET		ISSUE
			1		A

DATE OF MODIFIED BY	DATE OF MODIFIED BY	FIRST MADE ORN No.	ISSUE	MATERIAL	FINISH
		118764	1	STEEL	SEE ABOVE
DATE OF MODIFIED BY	DATE OF MODIFIED BY	FIRST ISSUE DATE	COST ACCOUNT	PART No.	
			202		
DATE OF MODIFIED BY	DATE OF MODIFIED BY	TITLE	WEIGHT	SCALE	UNIT No.
		COVER PLATE	6.1 kg	1/5	TC1.202.08
			No. OFF PER SET		ISSUE
			2		A

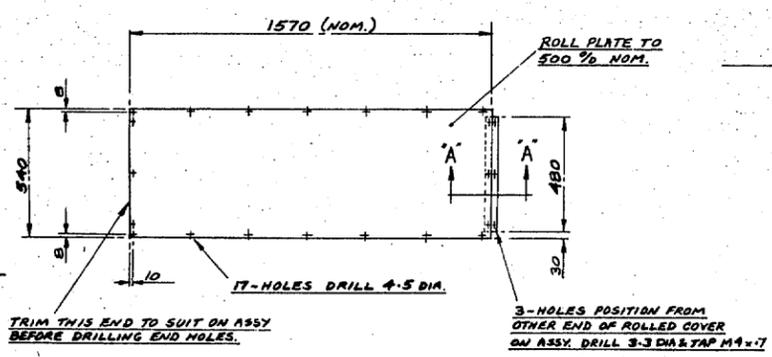

JOINING STRAP POP RIVETED TO COVER PLATE (4/8 DIA. RIVETS)

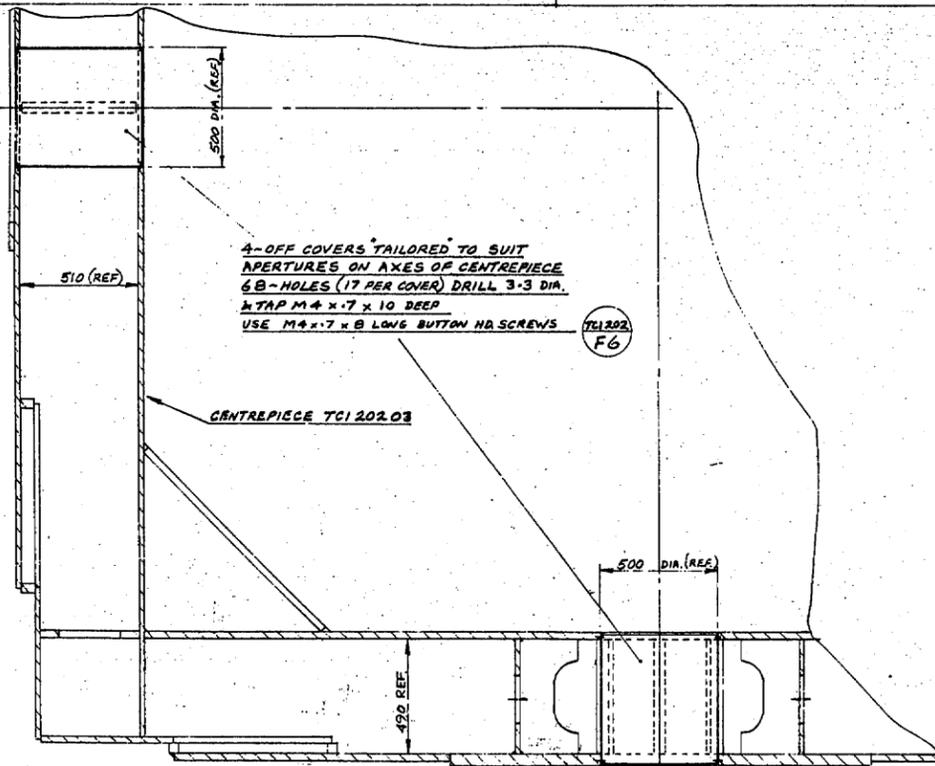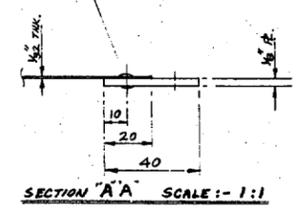

FREEMAN FOX & PARTNERS
APPROVED
No. TC1.202.09
Date 19.12.1983

DATE OF MODIFIED BY	DATE OF MODIFIED BY	FIRST MADE ORN No.	ISSUE	MATERIAL	FINISH
		118764	1	STEEL	SEE ABOVE
DATE OF MODIFIED BY	DATE OF MODIFIED BY	FIRST ISSUE DATE	COST ACCOUNT	PART No.	
			202		
DATE OF MODIFIED BY	DATE OF MODIFIED BY	TITLE	WEIGHT	SCALE	UNIT No.
		COVERS	1.1 kg	1/10	TC1.202.09
			No. OFF PER SET		ISSUE
			4		A

AS BUILT DRAWINGS
This drawing shows all variations to the work.

4.2 METRE WILLIAMS WEL TELESCOPE
OBSERVING DECK ABOVE DECK 15
GRUBB PARSONS NEWCASTLE UPON TYNE NE6 2YB
DETAILS OF CENTRE SECTION.
SCALE: 1:1
UNIT No. TC1.202.06-09