
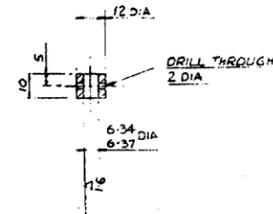
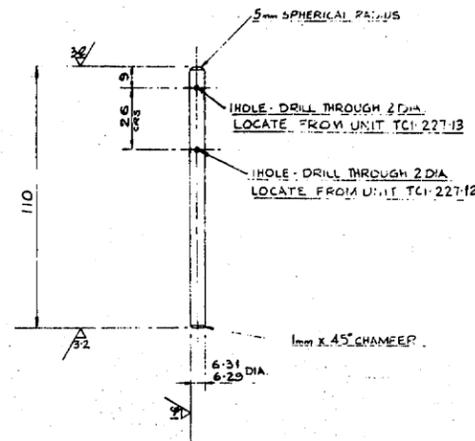


M.A.O. EXCEPT WHERE STATED

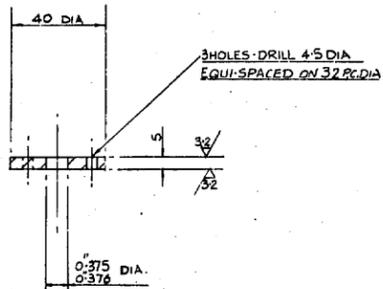


M.A.O. EXCEPT WHERE STATED

DATE OF MOD. REQUIRED BY	DATE OF MOD. REQUIRED BY	FIRST MADE ORD. No. 118660	MATERIAL 20' CARBON STEEL
DATE OF MOD. REQUIRED BY	DATE OF MOD. REQUIRED BY	FIRST ISSUE DATE 2-3-57	FINISH
DATE OF MOD. REQUIRED BY	DATE OF MOD. REQUIRED BY	COST ACCOUNT 227	PART No.
DATE OF MOD. REQUIRED BY	DATE OF MOD. REQUIRED BY	TITLE HOUSING	UNIT No. TCI-227-09
DATE OF MOD. REQUIRED BY	DATE OF MOD. REQUIRED BY	WEIGHT 0.024	SCALE 1:1
DATE OF MOD. REQUIRED BY	DATE OF MOD. REQUIRED BY	No. OFF PER SET 3	UNIT No. TCI-227-09



DATE OF MOD. REQUIRED BY	DATE OF MOD. REQUIRED BY	FIRST MADE ORD. No. 118660	MATERIAL 20' CARBON STEEL
DATE OF MOD. REQUIRED BY	DATE OF MOD. REQUIRED BY	FIRST ISSUE DATE 2-3-57	FINISH
DATE OF MOD. REQUIRED BY	DATE OF MOD. REQUIRED BY	COST ACCOUNT 227	PART No.
DATE OF MOD. REQUIRED BY	DATE OF MOD. REQUIRED BY	TITLE SPACER	UNIT No. TCI-227-10
DATE OF MOD. REQUIRED BY	DATE OF MOD. REQUIRED BY	WEIGHT 0.024	SCALE 1:1
DATE OF MOD. REQUIRED BY	DATE OF MOD. REQUIRED BY	No. OFF PER SET 3	UNIT No. TCI-227-10

DATE OF MOD. REQUIRED BY	DATE OF MOD. REQUIRED BY	FIRST MADE ORD. No. 118660	MATERIAL 20' CARBON STEEL
DATE OF MOD. REQUIRED BY	DATE OF MOD. REQUIRED BY	FIRST ISSUE DATE 2-3-57	FINISH
DATE OF MOD. REQUIRED BY	DATE OF MOD. REQUIRED BY	COST ACCOUNT 227	PART No.
DATE OF MOD. REQUIRED BY	DATE OF MOD. REQUIRED BY	TITLE ROD	UNIT No. TCI-227-11
DATE OF MOD. REQUIRED BY	DATE OF MOD. REQUIRED BY	WEIGHT 0.024	SCALE 1:1
DATE OF MOD. REQUIRED BY	DATE OF MOD. REQUIRED BY	No. OFF PER SET 3	UNIT No. TCI-227-11

DATE OF MOD. REQUIRED BY	DATE OF MOD. REQUIRED BY	FIRST MADE ORD. No. 118660	MATERIAL 20' CARBON STEEL
DATE OF MOD. REQUIRED BY	DATE OF MOD. REQUIRED BY	FIRST ISSUE DATE 2-3-57	FINISH
DATE OF MOD. REQUIRED BY	DATE OF MOD. REQUIRED BY	COST ACCOUNT 227	PART No.
DATE OF MOD. REQUIRED BY	DATE OF MOD. REQUIRED BY	TITLE SLEEVE	UNIT No. TCI-227-12
DATE OF MOD. REQUIRED BY	DATE OF MOD. REQUIRED BY	WEIGHT -	SCALE 1:1
DATE OF MOD. REQUIRED BY	DATE OF MOD. REQUIRED BY	No. OFF PER SET 3	UNIT No. TCI-227-12

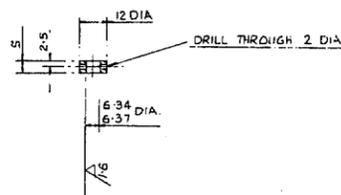

M.A.O. EXCEPT WHERE STATED

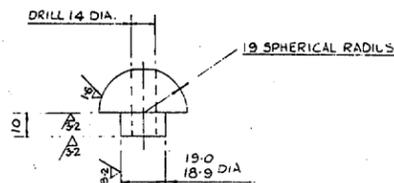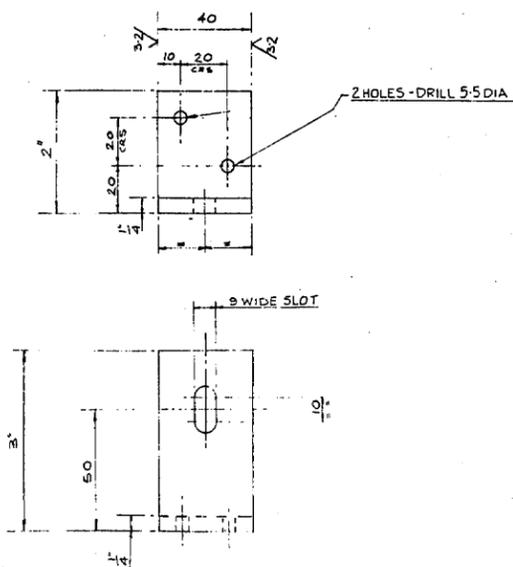

DRILL 5.5 DIA

NOTE TO BE MACHINED AND THEN HARDENED TO SOCIETY SPEC. PROCESS SPEC. NO. 55.1. TEMPERATURE 300 C.

AS BUILT DRAWINGS





APPROVED

DATE OF MOD. REQUIRED BY	DATE OF MOD. REQUIRED BY	FIRST MADE ORD. No. 118660	MATERIAL STAINLESS STEEL
DATE OF MOD. REQUIRED BY	DATE OF MOD. REQUIRED BY	FIRST ISSUE DATE 2-3-57	FINISH
DATE OF MOD. REQUIRED BY	DATE OF MOD. REQUIRED BY	COST ACCOUNT 227	PART No.
DATE OF MOD. REQUIRED BY	DATE OF MOD. REQUIRED BY	TITLE SLEEVE	UNIT No. TCI-227-13
DATE OF MOD. REQUIRED BY	DATE OF MOD. REQUIRED BY	WEIGHT -	SCALE 1:1
DATE OF MOD. REQUIRED BY	DATE OF MOD. REQUIRED BY	No. OFF PER SET 3	UNIT No. TCI-227-13




DATE OF MOD. REQUIRED BY	DATE OF MOD. REQUIRED BY	FIRST MADE ORD. No. 118660	MATERIAL AL ALLOY
DATE OF MOD. REQUIRED BY	DATE OF MOD. REQUIRED BY	FIRST ISSUE DATE 2-3-57	FINISH
DATE OF MOD. REQUIRED BY	DATE OF MOD. REQUIRED BY	COST ACCOUNT 227	PART No.
DATE OF MOD. REQUIRED BY	DATE OF MOD. REQUIRED BY	TITLE BRACKET	UNIT No. TCI-227-14
DATE OF MOD. REQUIRED BY	DATE OF MOD. REQUIRED BY	WEIGHT 0.03	SCALE 1:1
DATE OF MOD. REQUIRED BY	DATE OF MOD. REQUIRED BY	No. OFF PER SET 3	UNIT No. TCI-227-14

DATE OF MOD. REQUIRED BY	DATE OF MOD. REQUIRED BY	FIRST MADE ORD. No. 118660	MATERIAL STAINLESS STEEL
DATE OF MOD. REQUIRED BY	DATE OF MOD. REQUIRED BY	FIRST ISSUE DATE 2-3-57	FINISH
DATE OF MOD. REQUIRED BY	DATE OF MOD. REQUIRED BY	COST ACCOUNT 227	PART No.
DATE OF MOD. REQUIRED BY	DATE OF MOD. REQUIRED BY	TITLE BALL END	UNIT No. TCI-227-15
DATE OF MOD. REQUIRED BY	DATE OF MOD. REQUIRED BY	WEIGHT 0.024	SCALE 1:1
DATE OF MOD. REQUIRED BY	DATE OF MOD. REQUIRED BY	No. OFF PER SET 3	UNIT No. TCI-227-15

DATE OF MOD. REQUIRED BY	DATE OF MOD. REQUIRED BY	FIRST MADE ORD. No. 118660	MATERIAL STAINLESS STEEL
DATE OF MOD. REQUIRED BY	DATE OF MOD. REQUIRED BY	FIRST ISSUE DATE 2-3-57	FINISH
DATE OF MOD. REQUIRED BY	DATE OF MOD. REQUIRED BY	COST ACCOUNT 227	PART No.
DATE OF MOD. REQUIRED BY	DATE OF MOD. REQUIRED BY	TITLE BALL END	UNIT No. TCI-227-16
DATE OF MOD. REQUIRED BY	DATE OF MOD. REQUIRED BY	WEIGHT -	SCALE 1:1
DATE OF MOD. REQUIRED BY	DATE OF MOD. REQUIRED BY	No. OFF PER SET 3	UNIT No. TCI-227-16

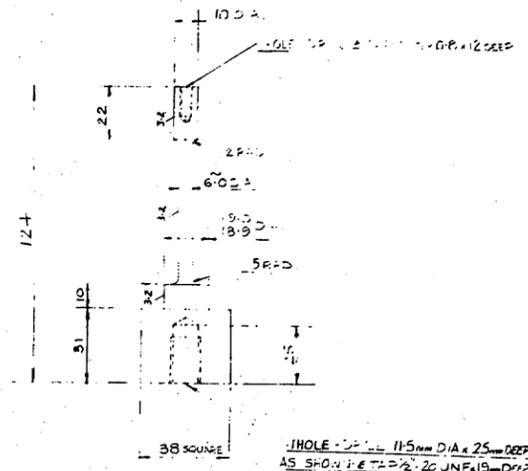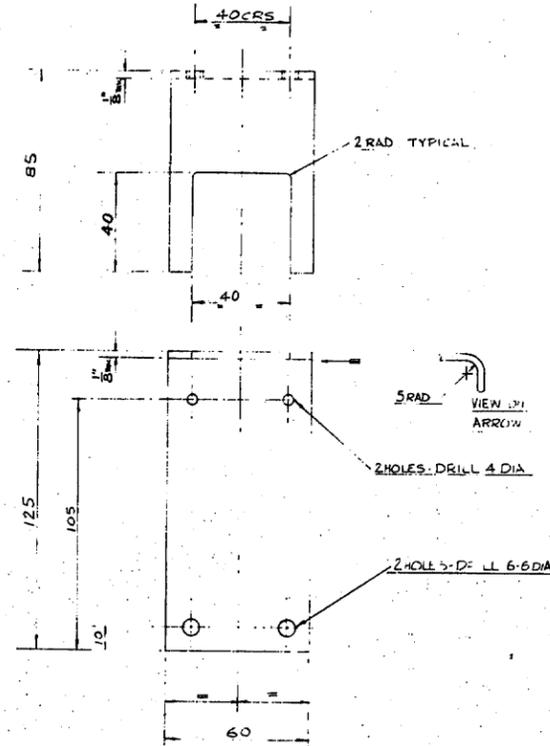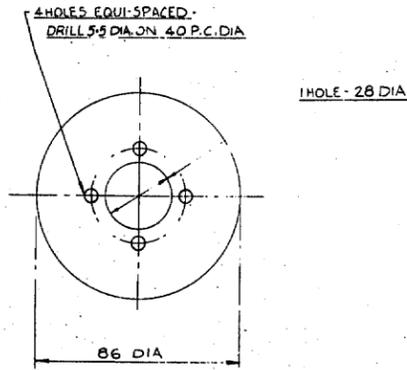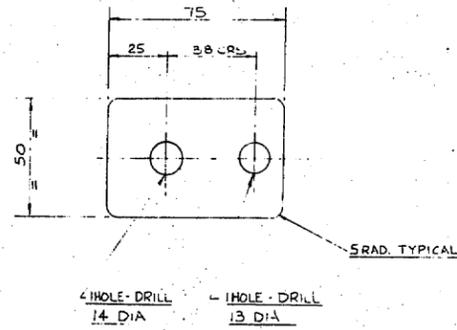

DATE OF MOD MODIFIED BY	DATE OF MOD MODIFIED BY	FIRST MADE ORD No. 118660	MATERIAL 1/8" M.S. PLATE	DATE OF MOD MODIFIED BY	DATE OF MOD MODIFIED BY	FIRST MADE ORD No. 118660	MATERIAL 1/8" M.S. PLATE	DATE OF MOD MODIFIED BY	DATE OF MOD MODIFIED BY	FIRST MADE ORD No. 118660	MATERIAL 1/8" M.S. PLATE	DATE OF MOD MODIFIED BY	DATE OF MOD MODIFIED BY	FIRST MADE ORD No. 118660	MATERIAL 1/8" M.S. PLATE		
		FIRST ISSUE DATE 2-3-87	FINISH WHITE OXID			FIRST ISSUE DATE 2-3-87	FINISH WHITE OXID			FIRST ISSUE DATE 2-3-87	FINISH WHITE OXID			FIRST ISSUE DATE 2-3-87	FINISH WHITE OXID		
		COST ACCOUNT 2.27	PART No.			COST ACCOUNT 2.27	PART No.			COST ACCOUNT 2.27	PART No.			COST ACCOUNT 2.27	PART No.		
		TITLE SWITCH MOUNT						TITLE BRACKET						TITLE ROD			
		WEIGHT 0.033 Kg	SCALE 1:1	UNIT No. TCI-227-17	ISSUE A			WEIGHT 0.27 Kg	SCALE 1:1	UNIT No. TCI-227-19	ISSUE A			WEIGHT 0.4 Kg	SCALE 1:1	UNIT No. TCI-227-20	ISSUE A
		CAM						CAM						CAM			

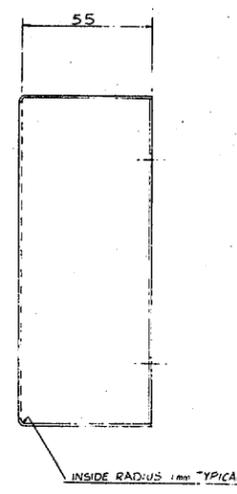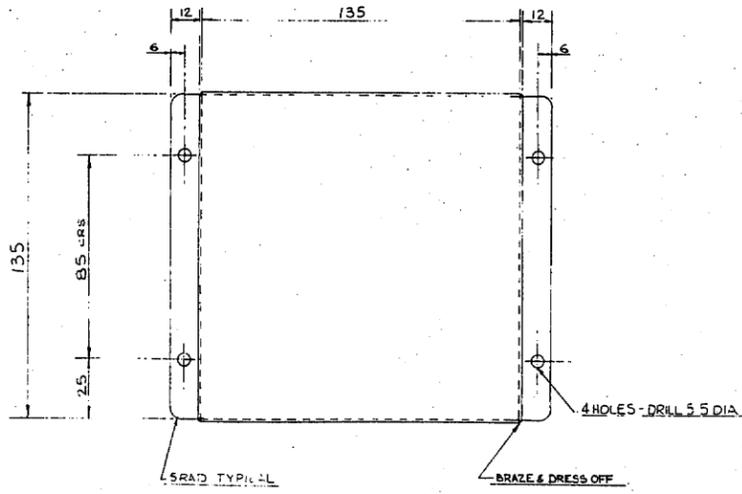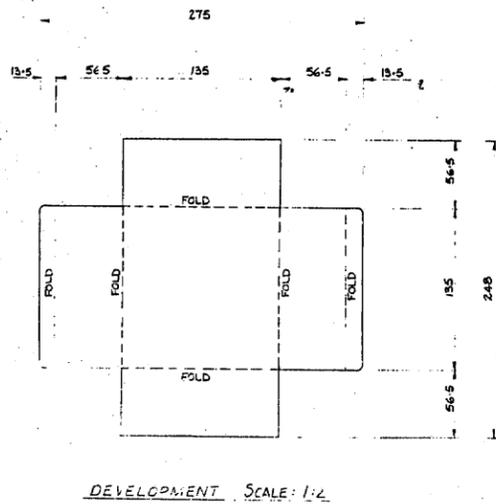

**AS BUILT DRAWINGS**  
This drawing shows all variations to the work.