

Royal Greenwich Observatory
La Palma Division
APPROVED
No. TCI.229.03 Rev. A
Date 11.5.82 by *[Signature]*

Royal Greenwich Observatory
La Palma Division
APPROVED
No. TCI.229.04 Rev. A
Date 11.5.82 by *[Signature]*

Royal Greenwich Observatory
La Palma Division
APPROVED
No. TCI.229.05 Rev. A
Date 11.5.82 by *[Signature]*


Royal Greenwich Observatory
La Palma Division
APPROVED
No. TCI.229.06 Rev. A
Date 11.5.82 by *[Signature]*

DATE OF MOD MODIFIED BY	DATE OF MOD MODIFIED BY	FIRST MADE ORD No. 118764	MATERIAL DIECAST Box 30 x 35 x 8
		FIRST ISSUE DATE	FINISH PAINT TO SPEC.
		COST ACCOUNT 229	PATT No.
TITLE Box DRILLING			
WEIGHT	SCALE 1:1	UNIT No. TCI 229.03	ISSUE A
No. OFF PER SET 1			


DATE OF MOD MODIFIED BY	DATE OF MOD MODIFIED BY	FIRST MADE ORD No. 118764	MATERIAL NYLON
		FIRST ISSUE DATE	FINISH NATURAL
		COST ACCOUNT 229	PATT No.
TITLE SENSOR MOUNT			
WEIGHT	SCALE 1:1	UNIT No. TCI 229.04	ISSUE A
No. OFF PER SET 1			

DATE OF MOD MODIFIED BY	DATE OF MOD MODIFIED BY	FIRST MADE ORD No. 118764	MATERIAL DIECAST Box 116 x 89 x 55
		FIRST ISSUE DATE	FINISH PAINT TO SPEC.
		COST ACCOUNT 229	PATT No.
TITLE Box DRILLING			
WEIGHT	SCALE 1:1	UNIT No. TCI 229.05	ISSUE A
No. OFF PER SET 1			

DATE OF MOD MODIFIED BY	DATE OF MOD MODIFIED BY	FIRST MADE ORD No. 118764	MATERIAL DIECAST Box 50 x 35 x 89
		FIRST ISSUE DATE	FINISH PAINT TO SPEC.
		COST ACCOUNT 229	PATT No.
TITLE Box DRILLING			
WEIGHT	SCALE 1:1	UNIT No. TCI 229.06	ISSUE A
No. OFF PER SET 5			

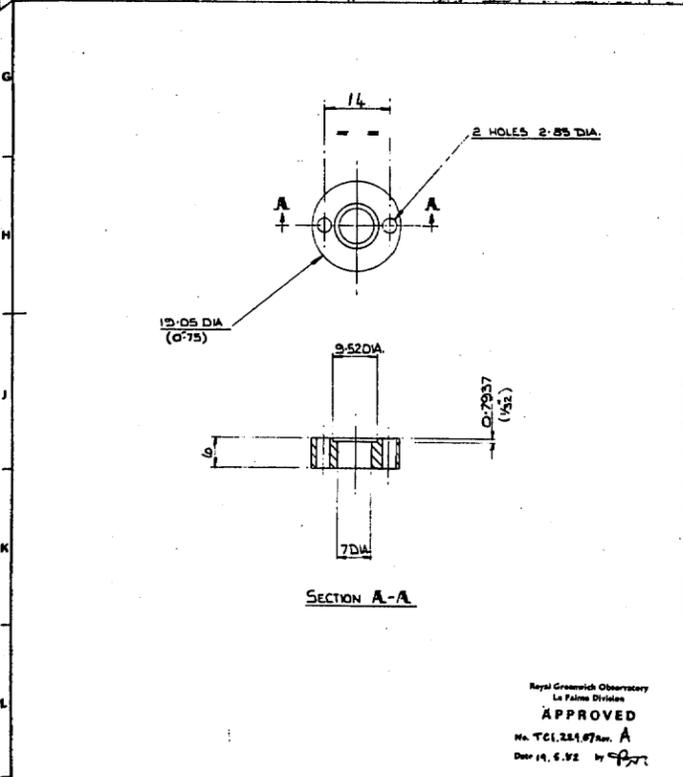

Royal Greenwich Observatory
La Palma Division
APPROVED
No. TCI.229.07 Rev. A
Date 19.5.82 by *[Signature]*

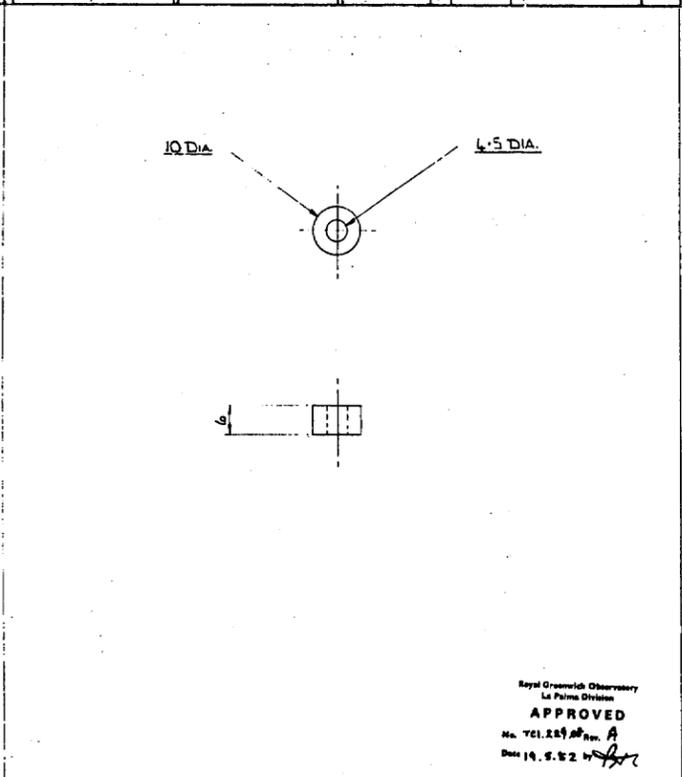

Royal Greenwich Observatory
La Palma Division
APPROVED
No. TCI.229.08 Rev. A
Date 19.5.82 by *[Signature]*

DATE OF MOD MODIFIED BY	DATE OF MOD MODIFIED BY	FIRST MADE ORD No. 118764	MATERIAL 3/4 DIA NYLON ROD
		FIRST ISSUE DATE	FINISH NATURAL
		COST ACCOUNT 229	PATT No.
TITLE SENSOR MOUNT			
WEIGHT	SCALE 2:1	UNIT No. TCI 229.07	ISSUE A
No. OFF PER SET 6			

DATE OF MOD MODIFIED BY	DATE OF MOD MODIFIED BY	FIRST MADE ORD No. 118764	MATERIAL 1/4 THK. GACO
		FIRST ISSUE DATE	FINISH NATURAL
		COST ACCOUNT 229	PATT No.
TITLE WASHER			
WEIGHT	SCALE 2:1	UNIT No. TCI 229.08	ISSUE A
No. OFF PER SET 14			

AS BUILT DRAWINGS
The drawing shows all variations to the work.

42 METRE WILLIAM HERSCHEL TELESCOPE
FOR
OBSERVATORIO DEL PUEBLO DE LAS PALMAS
LA PALMA
CANARY ISLANDS
ROYAL GREENWICH OBSERVATORY