



PANEL MOUNTING PLATE  
 TO BE USED FOR PANEL TYPE A  
 TO BE USED FOR PANEL TYPE B  
 TO BE USED FOR PANEL TYPE C  
 TO BE USED FOR PANEL TYPE D

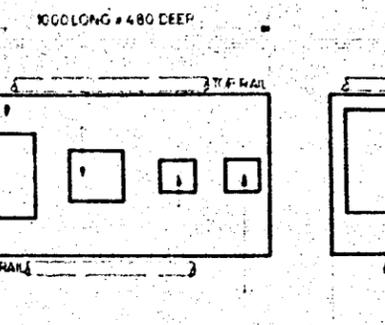


**PANEL TYPE A**  
 PANEL B SIMILAR  
 BUT WITHOUT FIRE  
 ALARM BREAK GLASS

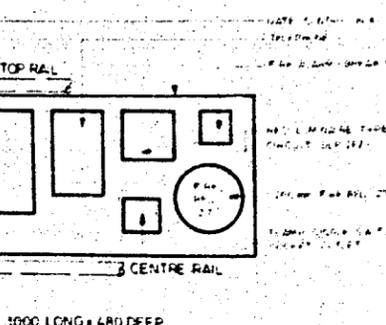

**PANEL TYPE C**  
 PANEL D SIMILAR  
 BUT WITHOUT TELEPHONE

**NOTES**  
 1 THE ELECTRICAL SERVICES INTERCONNECTING 3 COMPARTMENT TRUNKING AND ASSOCIATED CONDUITS FEEDING THIS AREA ARE SHOWN ON THE UNDER NASMYTH LEVEL WALKWAY ELECTRICAL SERVICES' DRG NO 1-41

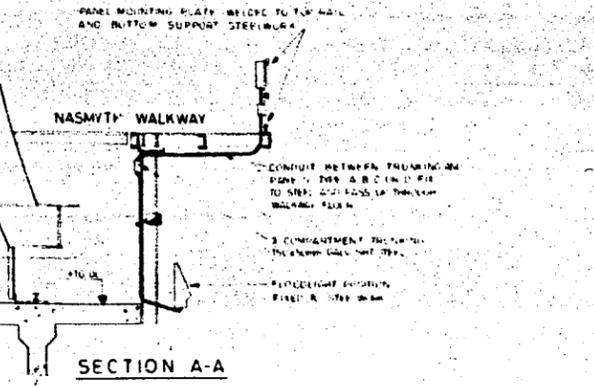


**AS INSTALLED**

Author	J.P.	17-4-80	
Modified	M.A.C.	18-3-81	
Checked	J.A.	30-1-86	
Drawn	A.J.G.		
Scale	D.S.		
Scale	1:50		
Scale	1:10		


CRESPO Y BLASCO  
 S. A.  
 ELECTRICIDAD

ISLA DE LA PALMA  
 ON THE NASMYTH  
 WALKWAY


1-40

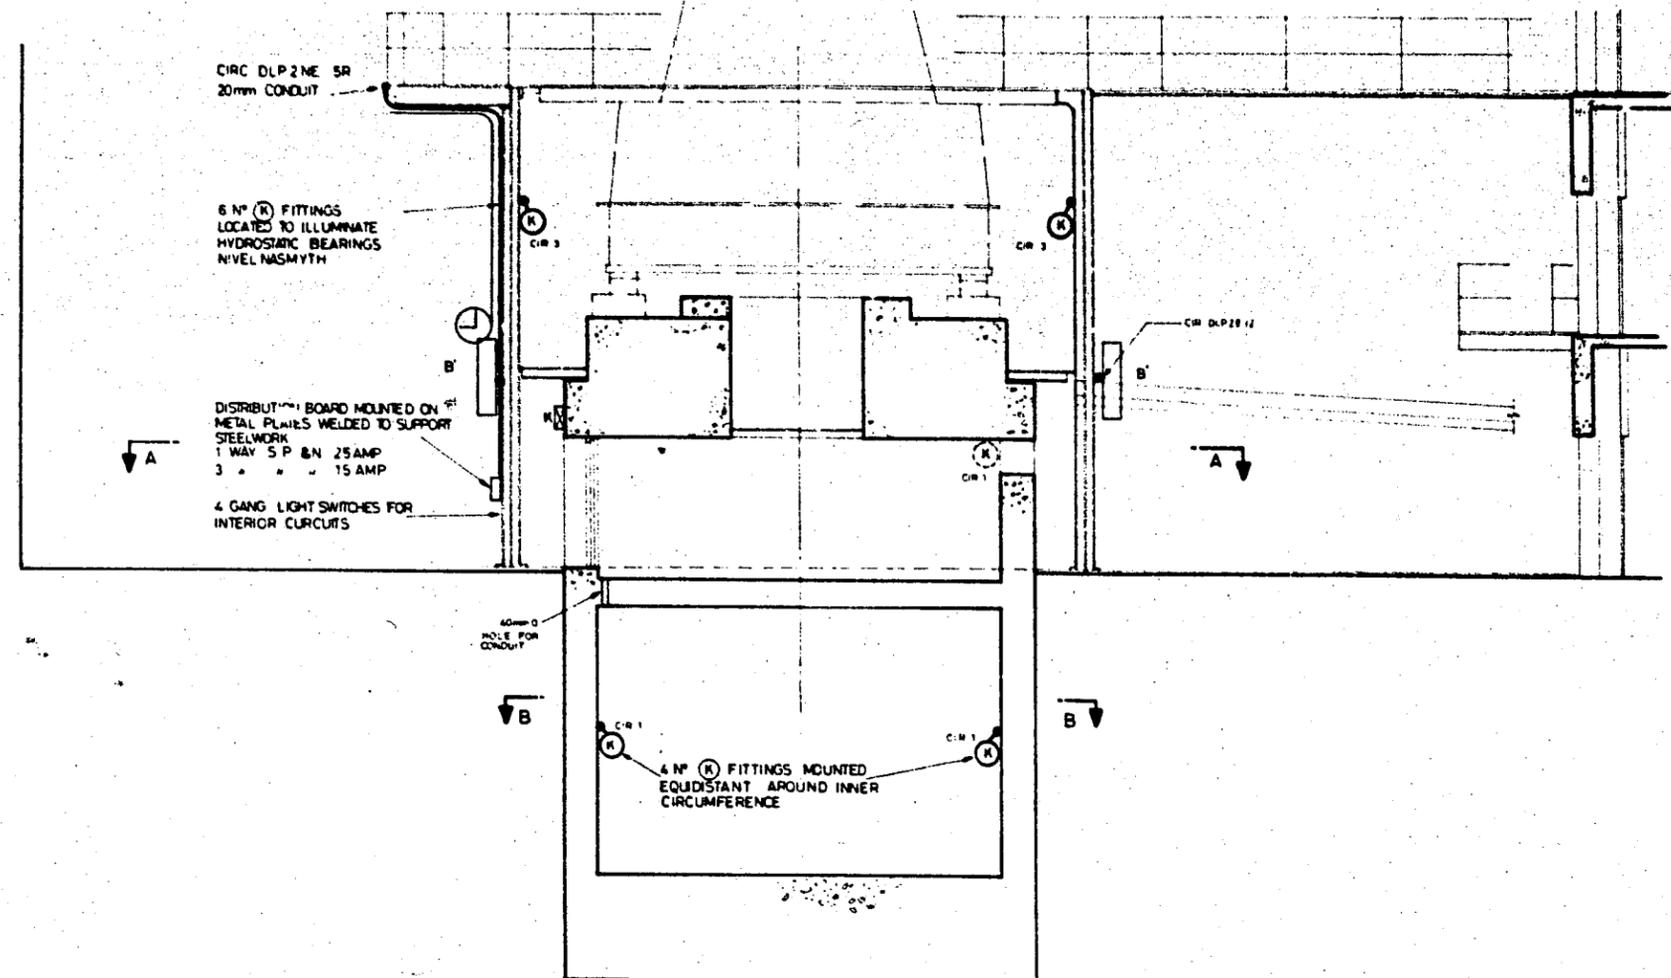

SECTION THROUGH DRUM

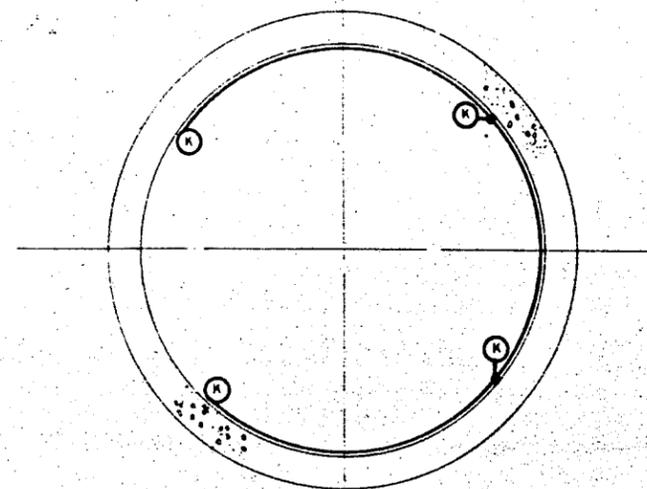

SECTION B-B

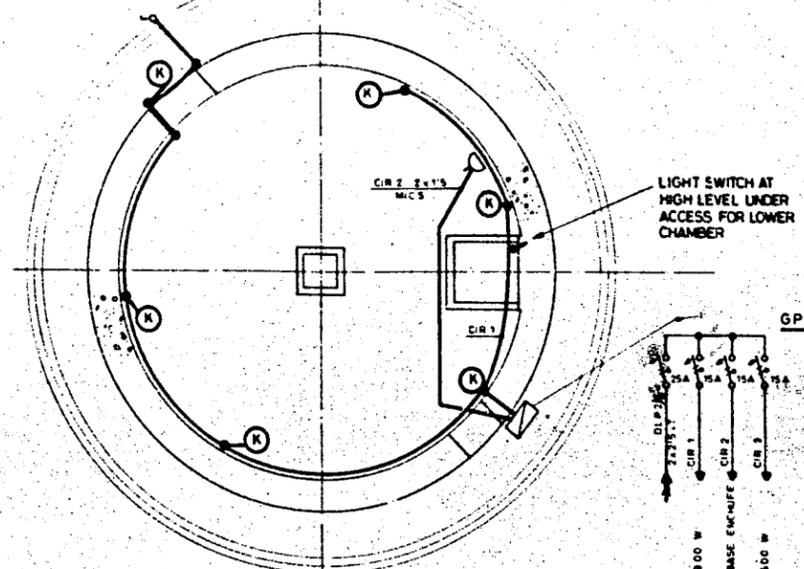

SECTION A-A

AS INSTALLED

Modificado	J P	17-4-86	
Modificado	J P	18-3-86	
Tarce	J A	29-1-86	
Diseño	A J G	" " "	
V. B.	D S	" " "	

**CRESPO Y BLASCO**  
S. A.  
ELECTRICIDAD

Escala	EDIFICIO DEL TELESCOPIO DE 4'2m	Plano N°
1/50	ISLA DE LA PALMA	I-43
	SECTIONS DRUM-GROUND FLOOR	