


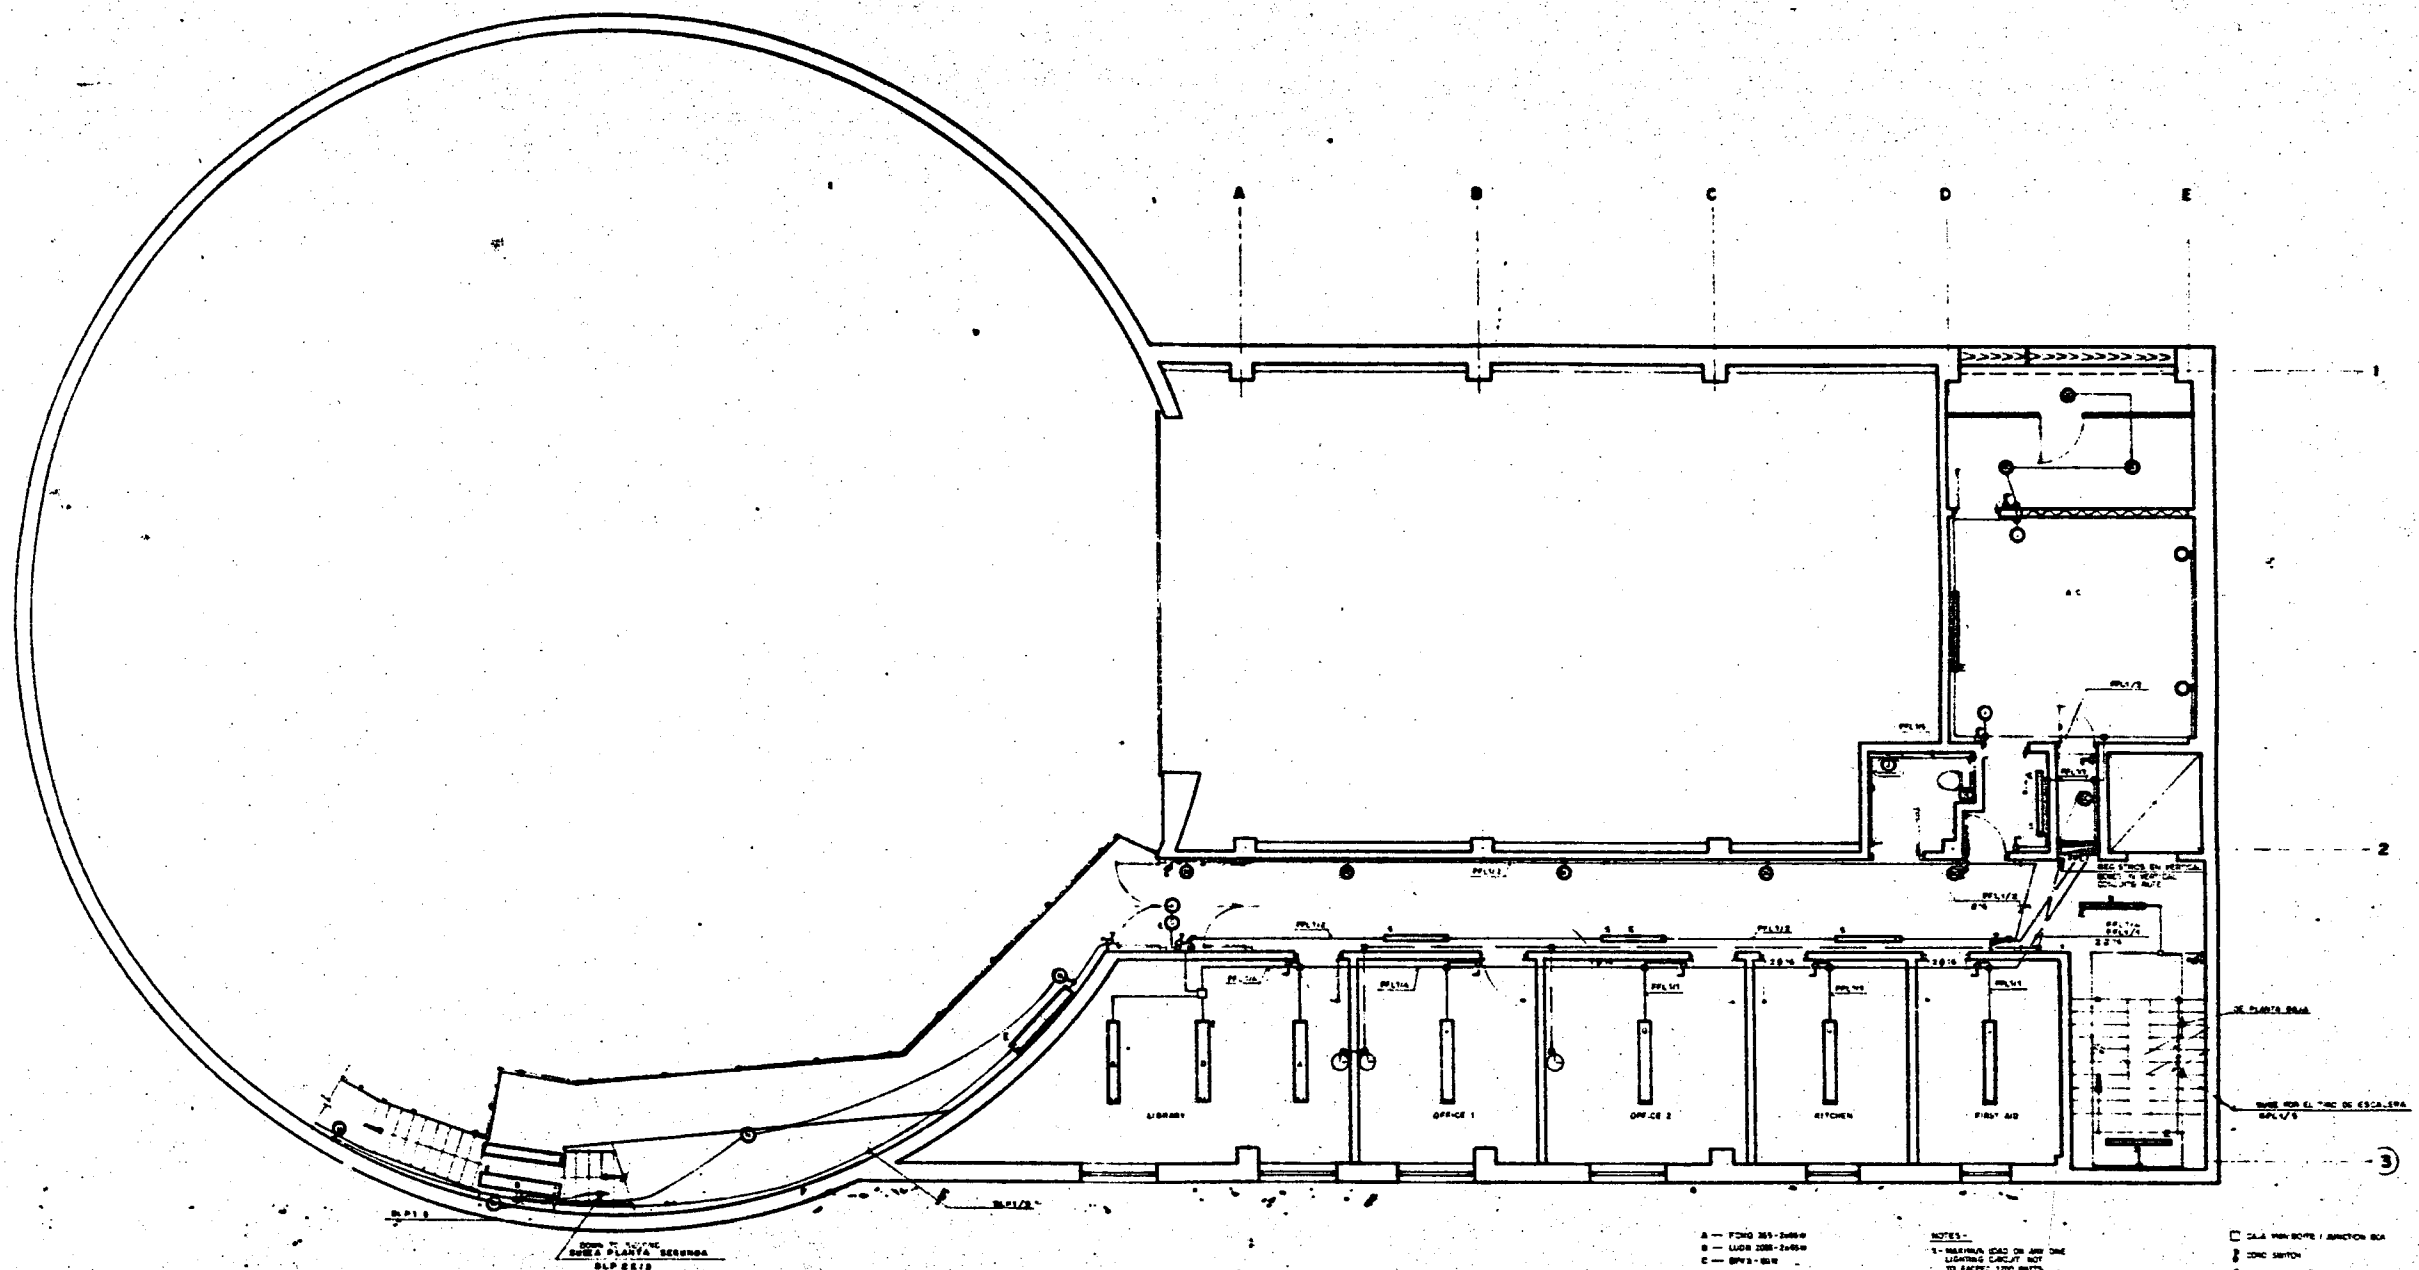

- A - FORD 351-2400 W  
 B - LION 2001-2400 W  
 C - OFFICE 1-2400 W  
 D - OFFICE 2-2400 W  
 E - OFFICE 3-2400 W  
 F - OFFICE 4-2400 W  
 G - OFFICE 5-2400 W  
 H - OFFICE 6-2400 W  
 I - OFFICE 7-2400 W  
 J - OFFICE 8-2400 W  
 K - OFFICE 9-2400 W  
 L - OFFICE 10-2400 W  
 M - OFFICE 11-2400 W  
 N - OFFICE 12-2400 W  
 O - OFFICE 13-2400 W  
 P - OFFICE 14-2400 W  
 Q - OFFICE 15-2400 W  
 R - OFFICE 16-2400 W  
 S - OFFICE 17-2400 W  
 T - OFFICE 18-2400 W  
 U - OFFICE 19-2400 W  
 V - OFFICE 20-2400 W  
 W - OFFICE 21-2400 W  
 X - OFFICE 22-2400 W  
 Y - OFFICE 23-2400 W  
 Z - OFFICE 24-2400 W

- 1 - MAXIMUM LOAD ON ANY ONE  
 LIGHTING CIRCUIT NOT  
 TO EXCEED 1200 WATTS  
 2 - AUTOMATIC EMERGENCY LIGHTING  
 UNITS INSTALLED IN ALL AREAS  
 ARE MARKED WITH "E"

- 1 - ONE WAY SWITCH  
 2 - TWO WAY SWITCH  
 3 - THREE WAY SWITCH  
 4 - DIMMER  
 5 - SILENT SWITCH  
 6 - SILENT SWITCH  
**AS INSTALLED**

|                                  |  |
|----------------------------------|--|
| CRESPO Y RASCO S.A. ELECTRICIDAD |  |
| 1-10                             |  |

1-10  
 10-3-96

