
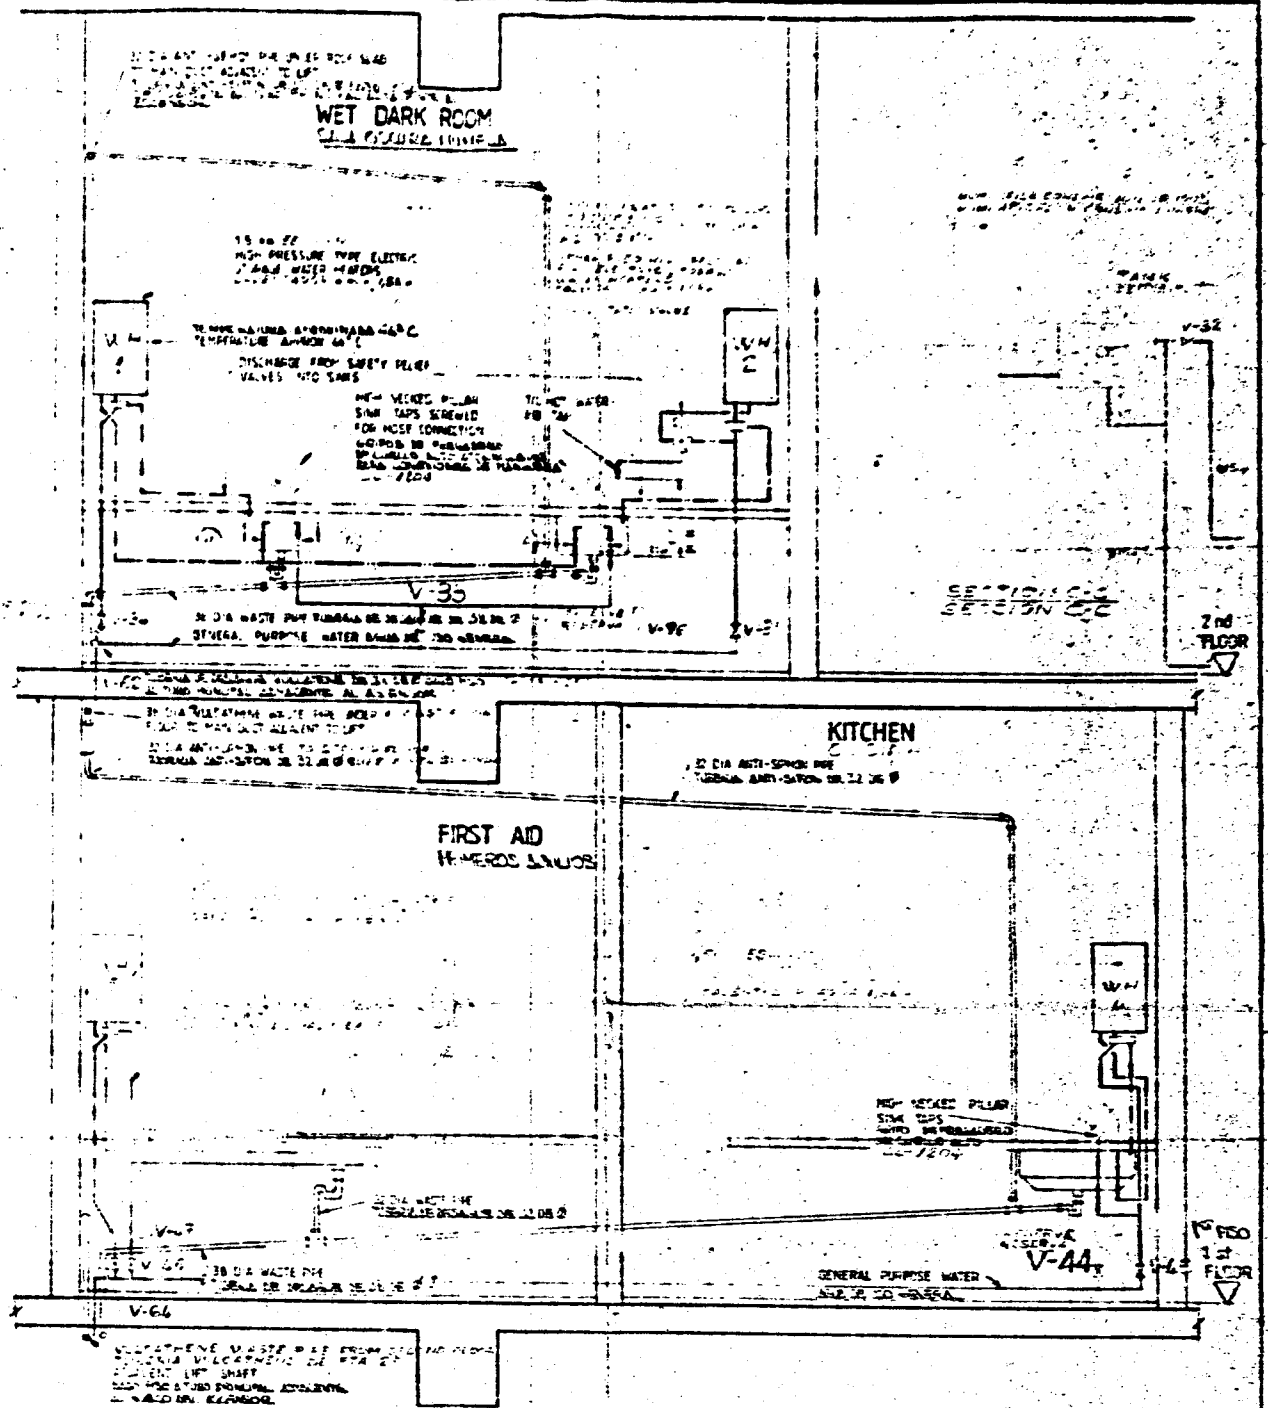
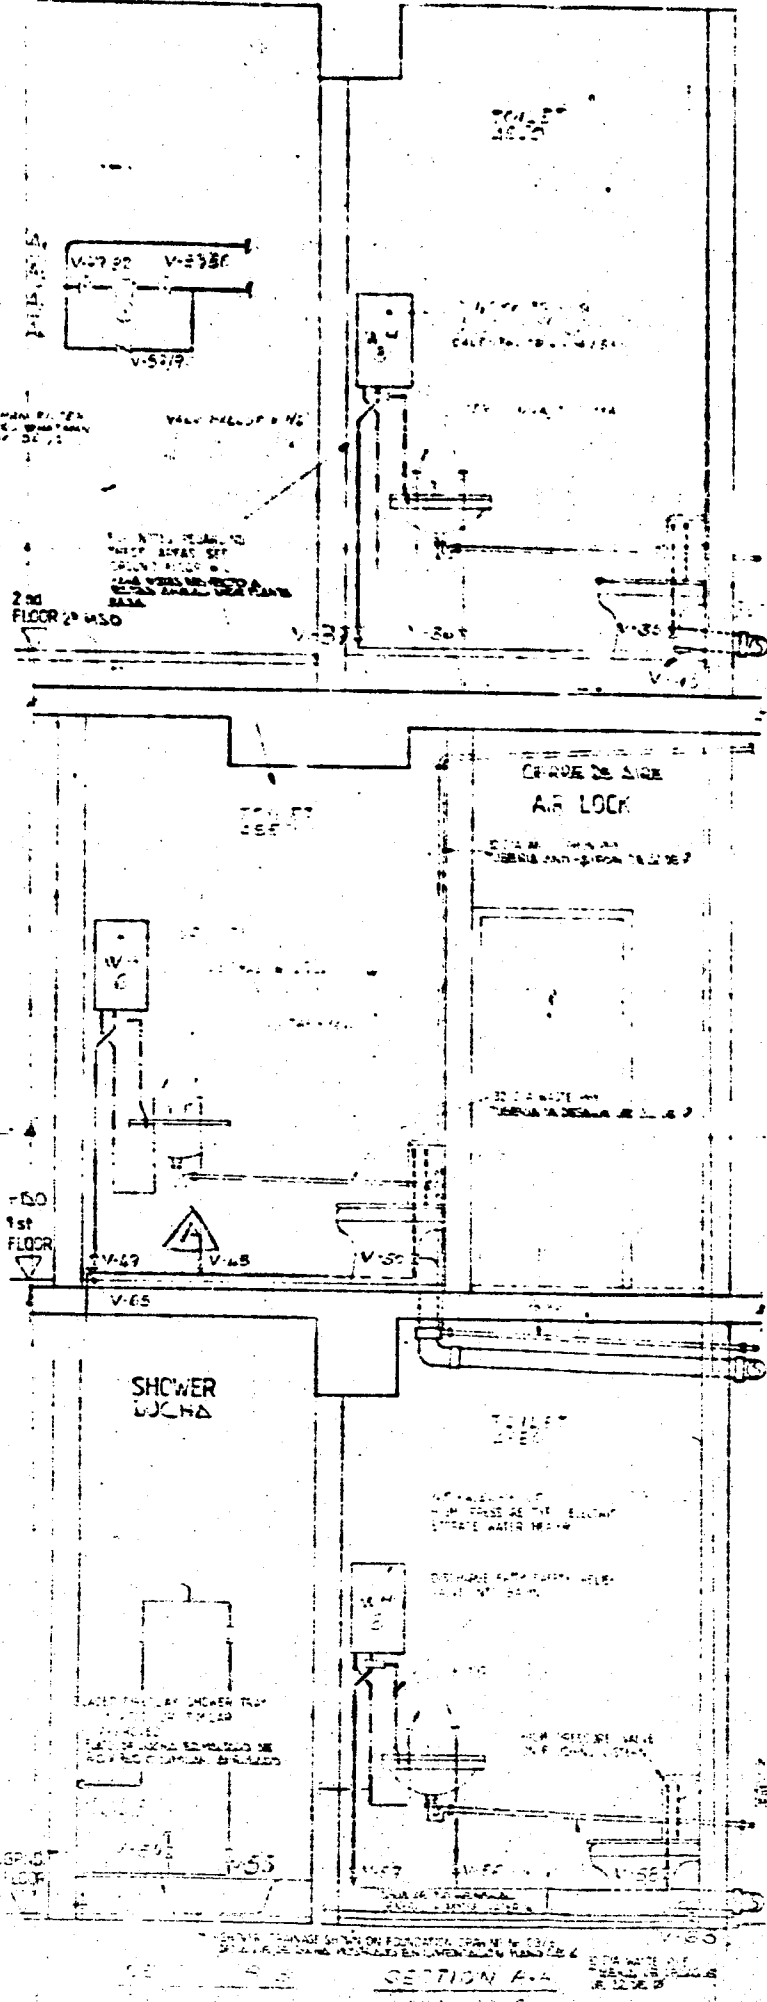



FOR SECTION C-C, SEE DRAWING NO 3095/C2/23
 PARA SECCION C-C, VER PLANO NO 3095/C2/23

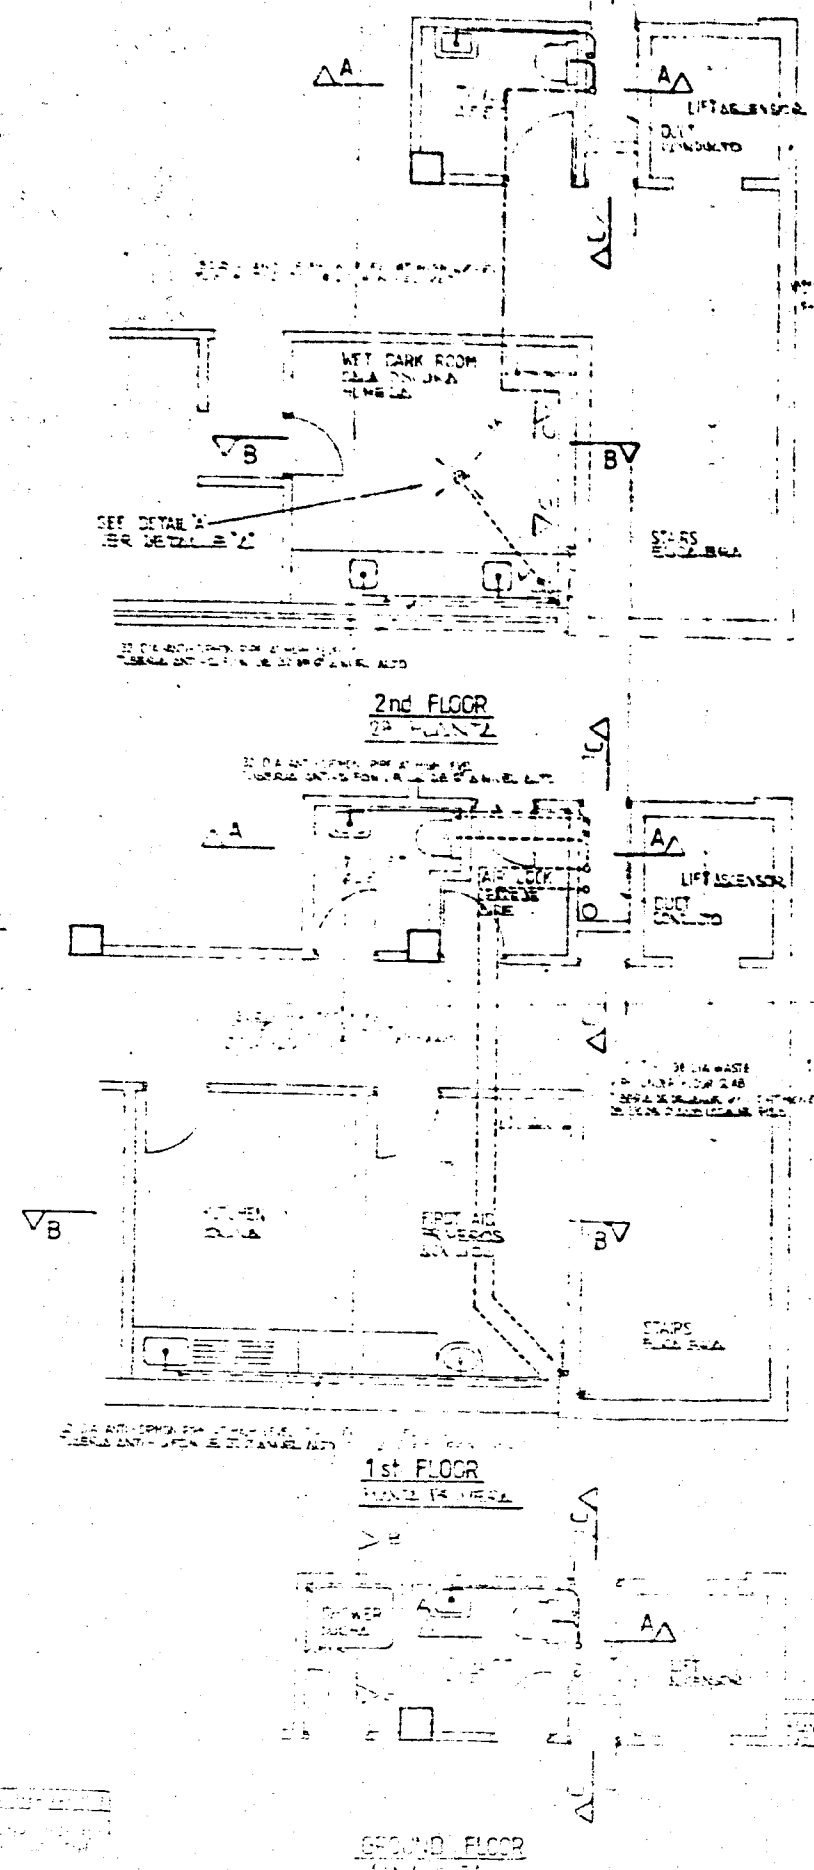

- NOTES**
1. WASTE AND VENTS FROM WET DARK ROOM ON SECOND FLOOR ARE 4" DIA. UNLESS OTHERWISE SPECIFIED. ALL FITTINGS SHALL BE BRASS OR BRASS EQUIVALENT. ALL VALVES SHALL BE BRASS OR BRASS EQUIVALENT.
 2. ALL OTHER WASTES ARE TO BE 1 1/2" DIA. UNLESS OTHERWISE SPECIFIED. ALL FITTINGS SHALL BE BRASS OR BRASS EQUIVALENT. ALL VALVES SHALL BE BRASS OR BRASS EQUIVALENT.
 3. ALL SINKS AND BATHTUBS SHALL BE 1 1/2" DIA. UNLESS OTHERWISE SPECIFIED. ALL FITTINGS SHALL BE BRASS OR BRASS EQUIVALENT. ALL VALVES SHALL BE BRASS OR BRASS EQUIVALENT.
 4. ALL CHASE FITTINGS IN GROUND FLOOR SLAB SHALL BE "EXTRA STRENGTH" INTERFLEX (L.I.) UNLESS OTHERWISE SPECIFIED. ALL FITTINGS SHALL BE BRASS OR BRASS EQUIVALENT. ALL VALVES SHALL BE BRASS OR BRASS EQUIVALENT.
 5. PIPE HANGERS ARE TO BE OF A TYPE APPROVED BY THE ENGINEER AND SPECIFIED IN THE SPECIFICATIONS. ALL FITTINGS SHALL BE BRASS OR BRASS EQUIVALENT. ALL VALVES SHALL BE BRASS OR BRASS EQUIVALENT.

- NOTES**
1. HOT AND COLD WATER CONNECTIONS SHALL BE 1/2" DIA. UNLESS OTHERWISE SPECIFIED. ALL FITTINGS SHALL BE BRASS OR BRASS EQUIVALENT. ALL VALVES SHALL BE BRASS OR BRASS EQUIVALENT.
 2. ALL OTHER WASTES ARE TO BE 1 1/2" DIA. UNLESS OTHERWISE SPECIFIED. ALL FITTINGS SHALL BE BRASS OR BRASS EQUIVALENT. ALL VALVES SHALL BE BRASS OR BRASS EQUIVALENT.
 3. ALL SINKS AND BATHTUBS SHALL BE 1 1/2" DIA. UNLESS OTHERWISE SPECIFIED. ALL FITTINGS SHALL BE BRASS OR BRASS EQUIVALENT. ALL VALVES SHALL BE BRASS OR BRASS EQUIVALENT.
 4. ALL CHASE FITTINGS IN GROUND FLOOR SLAB SHALL BE "EXTRA STRENGTH" INTERFLEX (L.I.) UNLESS OTHERWISE SPECIFIED. ALL FITTINGS SHALL BE BRASS OR BRASS EQUIVALENT. ALL VALVES SHALL BE BRASS OR BRASS EQUIVALENT.
 5. PIPE HANGERS ARE TO BE OF A TYPE APPROVED BY THE ENGINEER AND SPECIFIED IN THE SPECIFICATIONS. ALL FITTINGS SHALL BE BRASS OR BRASS EQUIVALENT. ALL VALVES SHALL BE BRASS OR BRASS EQUIVALENT.

REV.	Modificaciones	Comp.	Aprob.
ORENSE N.º 4 MADRID (28)			
ACOYSA			
INGENIEROS INDUSTRIALES			
TELEFONO 4 55 09 00			
OBRA: EDIFICIO DEL TELESCOPIO DE 4,2 m OBSERVATORIO DEL ROQUE DE LOS MUCHACHOS			
DIRECCION: LA PALMA			
PLANIA			
INSTALACION DE CONEXIONES AGUA CALIENTE, FRIA Y DESAGUES (HOJA-1). HOT AND COLD WATER, WASTE AND INTERNAL DRAINAGE CONNECTIONS (SHEET-1)			
PLANO N.º 7031/6			

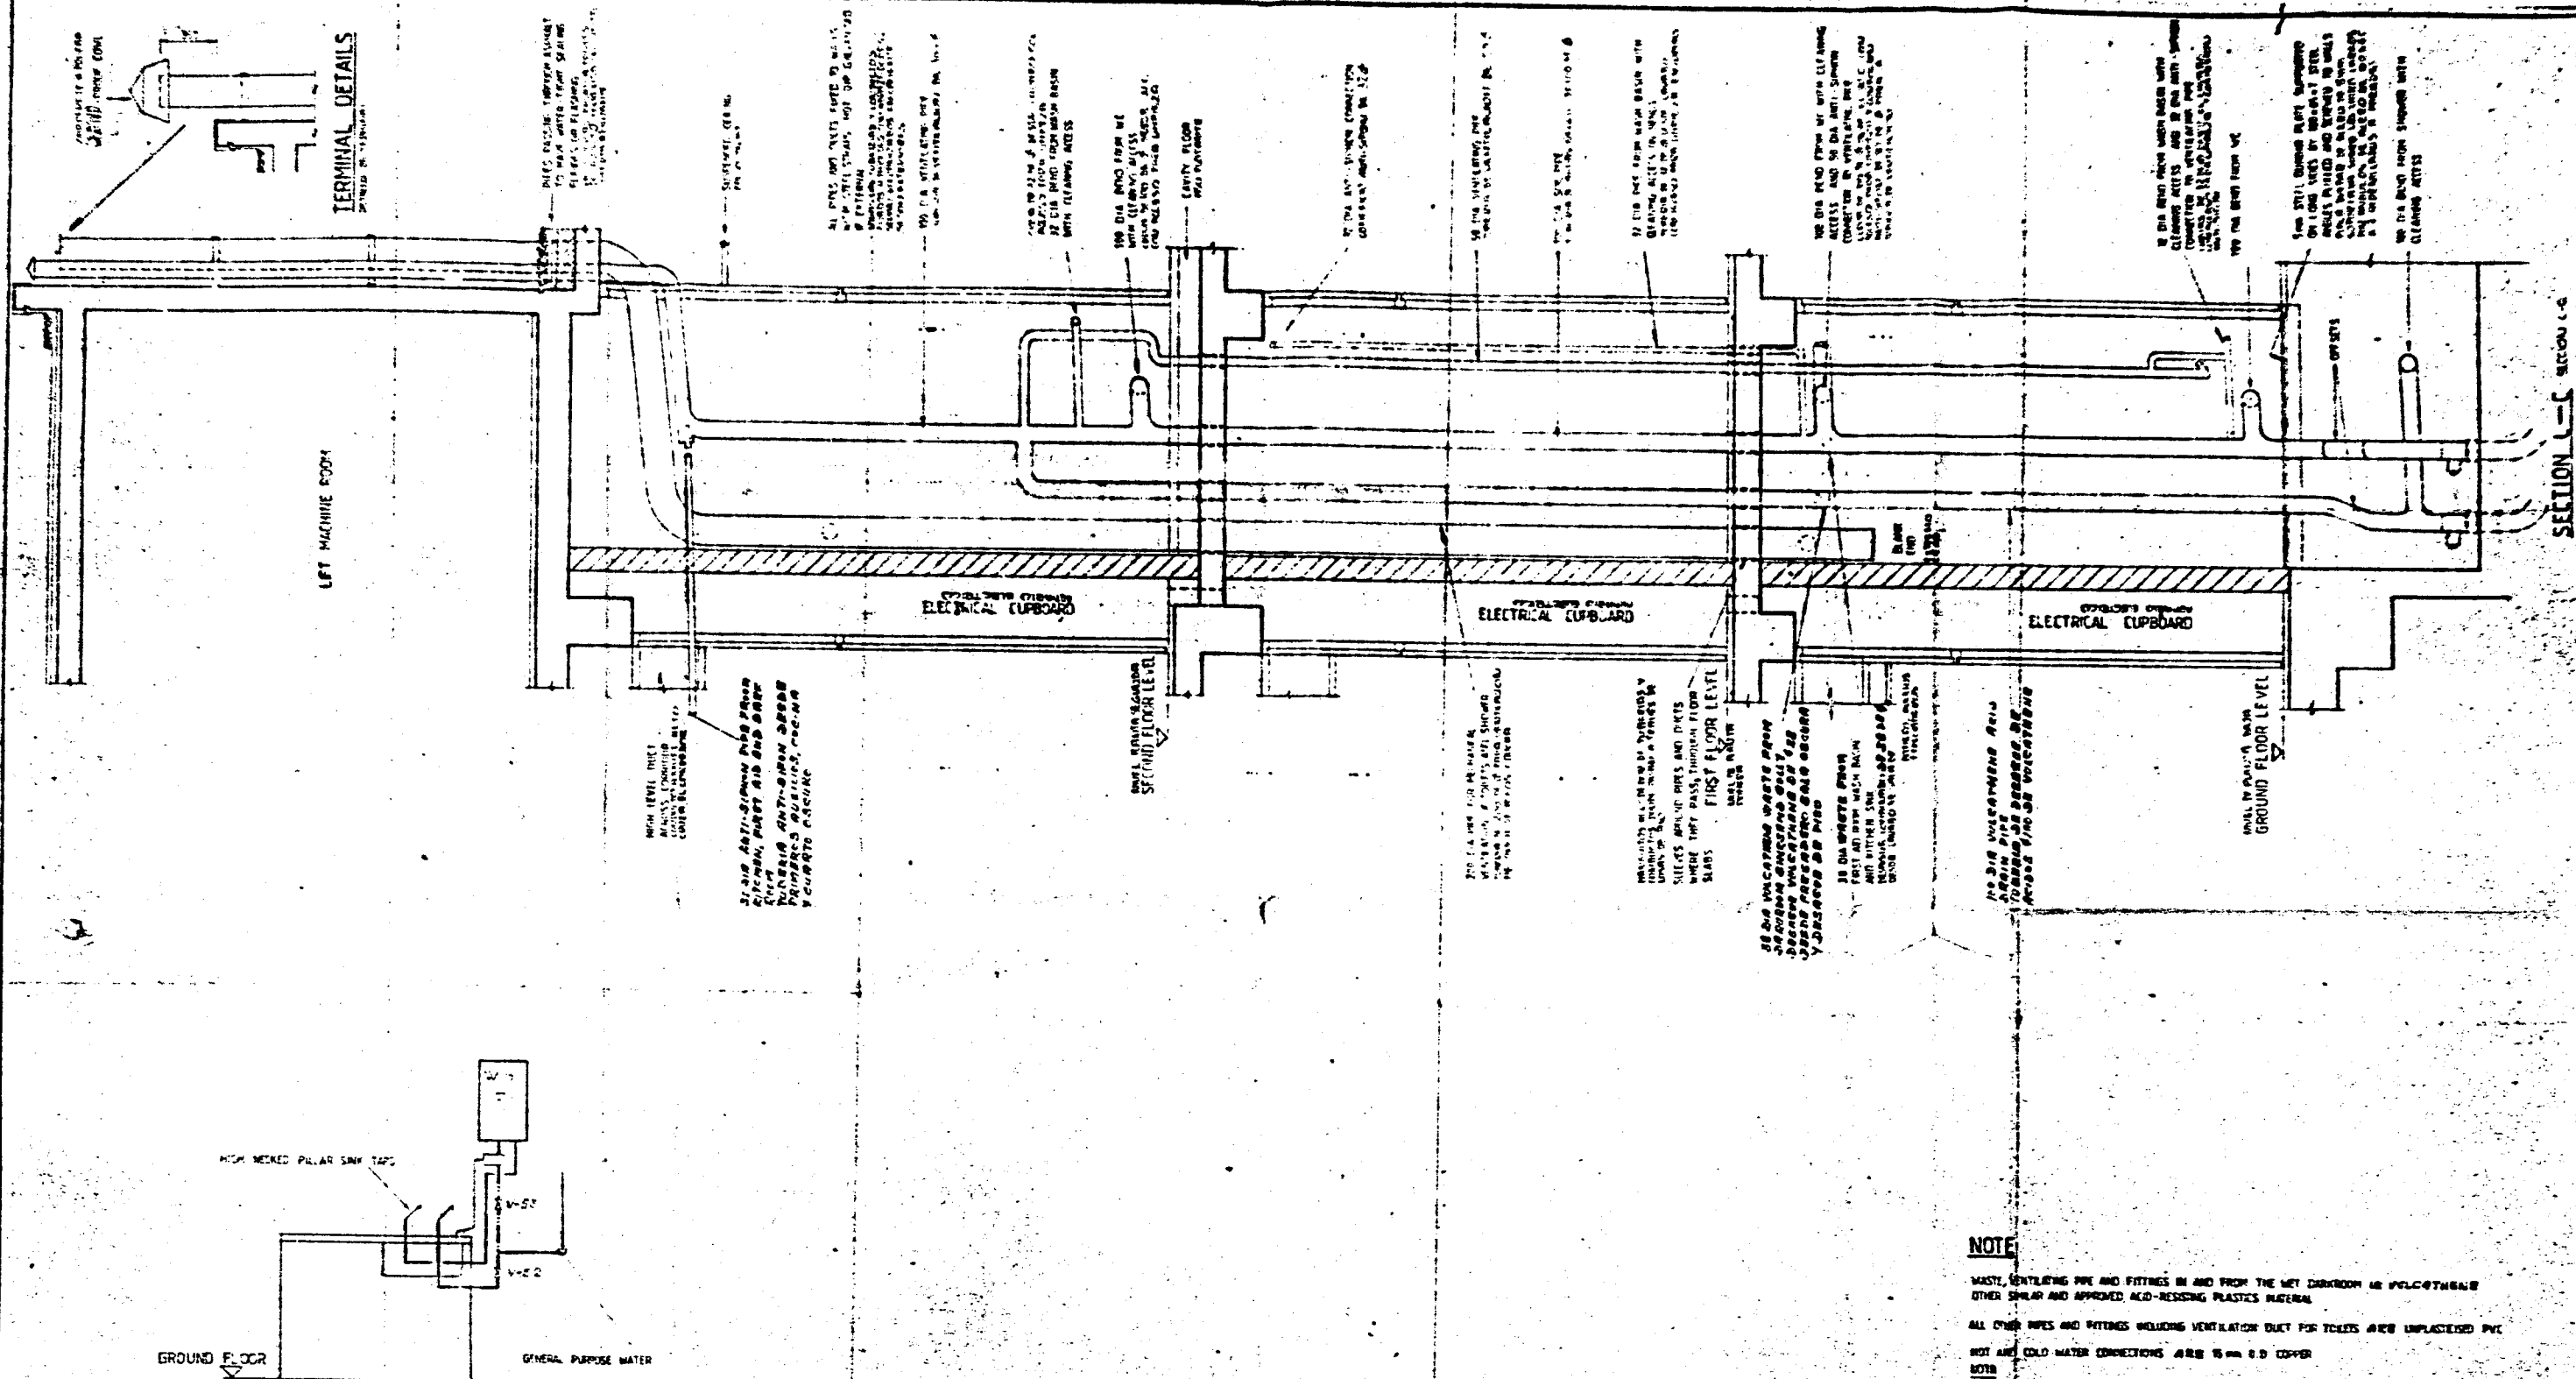

SECTION 3-1 NORTH

NOTE

WASTE, VENTILATING PIPE AND FITTINGS IN AND FROM THE WET DARKROOM ARE POLYETHYLENE
OTHER SIMILAR AND APPROVED ACID-RESISTING PLASTICS MATERIAL

ALL OTHER PIPES AND FITTINGS INCLUDING VENTILATION DUCT FOR TOILETS ARE UNPLASTICIZED PVC

HOT AND COLD WATER CONNECTIONS ARE 15mm O.D. COPPER

NOTE

LA TUBERÍA DE VENTILACIÓN Y ACCESORIOS EN Y FUERA DE LA SALA OSCURA
DEBERÁN SER VALVULAS Y OTAS SIMILARES Y APROBADAS DE MATERIAL PLÁSTICO RESISTENTE
A LOS ÁCIDOS

EL RESTO DE LA TUBERÍA Y ACCESORIOS INCLUIDO EN LA VENTILACIÓN DE LOS TOILETS
SERÁN DE PVC.

LOS CONEXIONES DE AGUA FRÍA Y CALIENTE SON DE 15mm EN DIAM.

AS INSTALLED

REV.	Modificaciones	Fecha	Elabor.	Comp.	Aprob.
ORDEN N.º ACOYSA TELEFONO MADRID (28) INGENIEROS INDUSTRIALES 8 55 09 59					
Elaborado	Nombre	OBRA:	EDIFICIO DEL TELESCOPIO DE 4,2m		
Comprobado		OBSERVATORIO DEL ROQUE DE LOS MUJACHOS			
Aprobado		DIRECCIÓN LA PALMA			
Escala	INSTALACION DE CONEXIONES AGUA CALIENTE, FRÍA Y DESAGUES (HOJA 2). HOT AND COLD WATER, WASTE AND INTERNAL DRAINAGE CONNECTIONS (SHEET 2)		PLANTA		
1:20			FOLIO N.º 7831/7		

REVISION B AUGUST 1963
RUE FROM WC CONNECTED TO
SHOWER AND CONNECTED TO
ACID/CHEMICAL DRAIN.
ANTI-SIPHON PIPE REMOVED
FROM THIS CONNECTION

REVISION A FEBRUARY 1963
SINK IN MIRROR WASHING
AREA SHOWN

SINK IN MIRROR WASHING AREA OF DRUM

GROUND FLOOR

GENERAL PURPOSE WATER

HIGH REELED PILLAR SINK TAPS

TERMINAL DETAILS

LIFT MACHINE ROOM

ELECTRICAL CUPBOARD

ELECTRICAL CUPBOARD

ELECTRICAL CUPBOARD

SECOND FLOOR LEVEL

FIRST FLOOR LEVEL

GROUND FLOOR LEVEL